




BLUE IMP RECOMMENDS THAT SLIDES BE INSTALLED WITH SLIDE BEDS FACING BETWEEN NORTH AND EAST

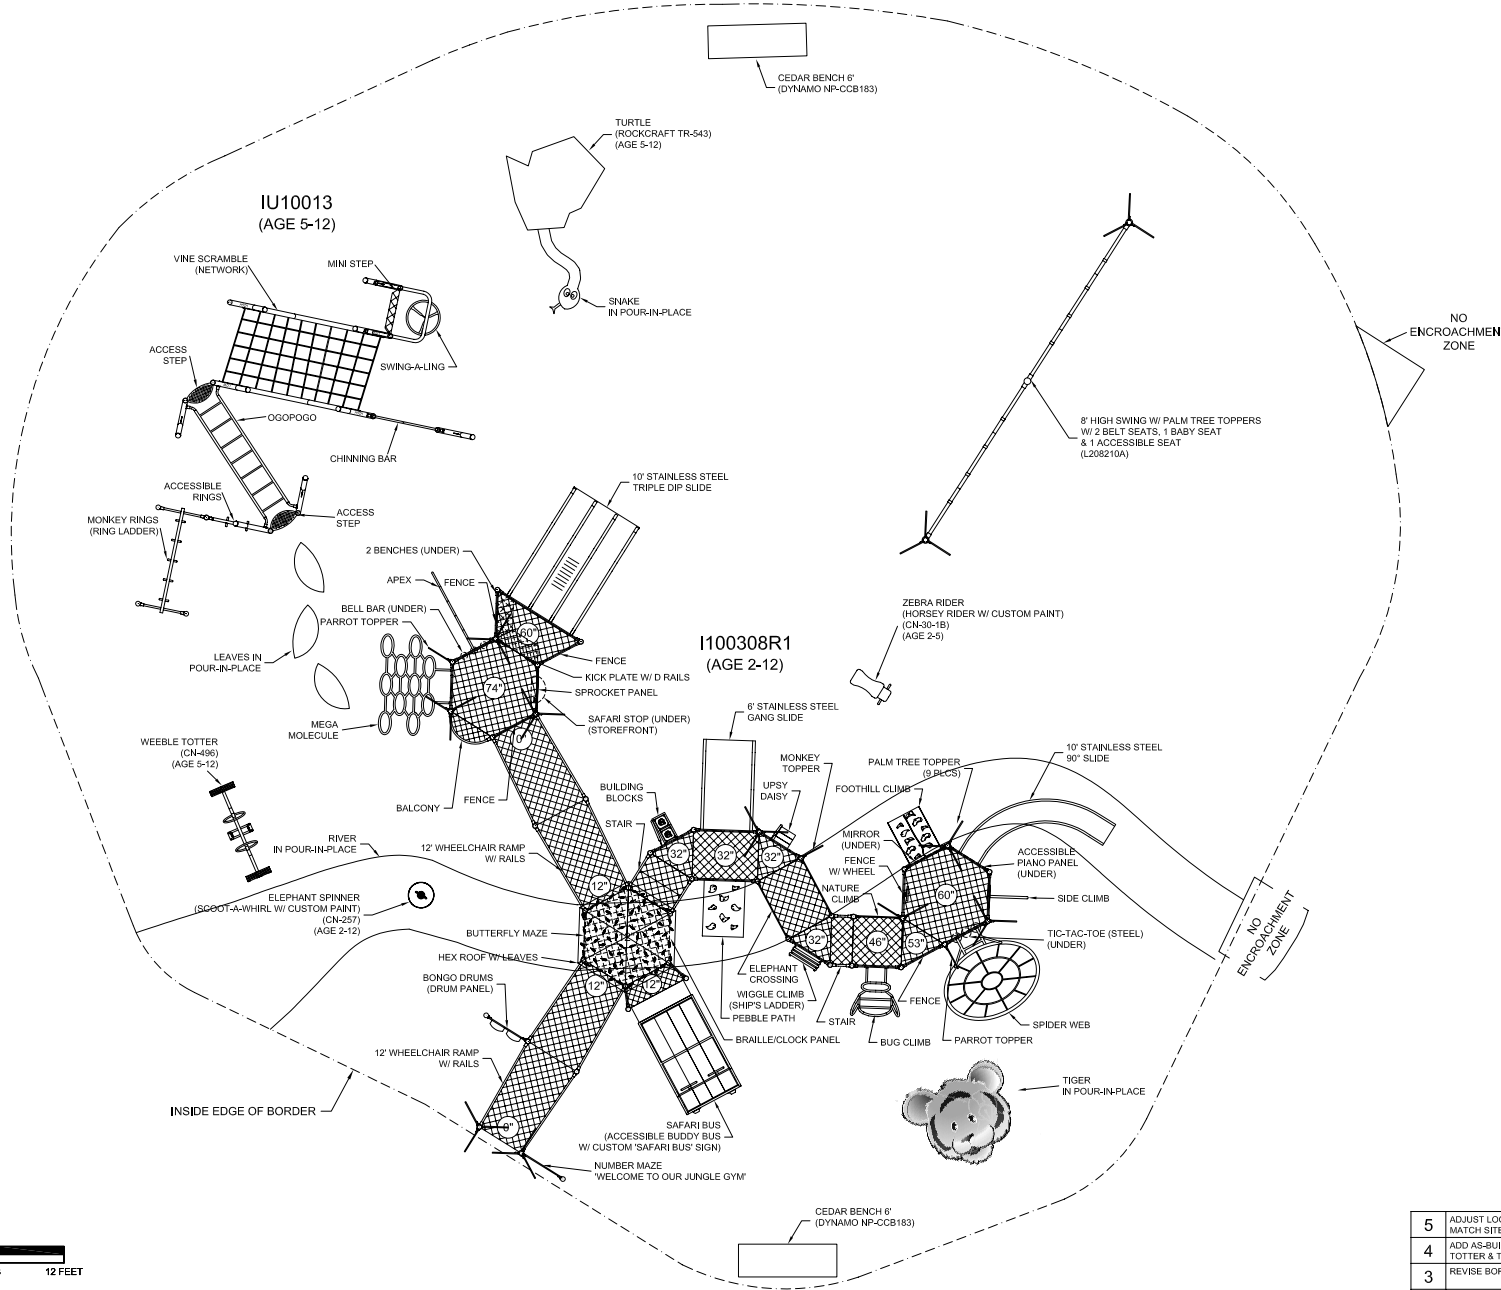

RECORD DRAWING

5	ADJUST LOCATIONS OF TIGER AND BENCH TO MATCH SITE AS BUILT.	EH	25-OCT-11
4	ADD AS-BUILT MEASUREMENTS, MOVE WEEBLE TOTTER & TURTLE, REVISE BORDER.	EH	5-AUG-11
3	REVISE BORDER, RE-ARRANGE EQUIPMENT.	EH	29-JUN-11
2	ALTER AREA	AW	03-JUN-11
1	ADD HEX ROOF W/ LEAVES	LB	08-FEB-11

CONFORMS TO THE CAN/CSA-Z614-07 STANDARD "CHILDREN'S PLAYSCAPES AND EQUIPMENT"

DRAWINGS AND SPECIFICATIONS ARE PROPERTY OF S.F. SCOTT MANUFACTURING. THIS DRAWING MAY NOT BE REPRODUCED IN WHOLE OR IN PART WITHOUT THE PRIOR WRITTEN CONSENT OF THE ENGINEERING DEPARTMENT.

CONFORMS TO ADA "AMERICANS WITH DISABILITIES ACT" (SUBJECT TO THE PRESENCE OF ACCESSIBLE SURFACING)

SOME BORDER DIMENSIONS ARE TO MINIMUM ALLOWANCE

AREA REQUIRED IS BASED UPON SUPPLIED SURVEY INFORMATION SHOWING LOCATION OF EXISTING EQUIPMENT AND BORDERS. EXACT LOCATION OF EXISTING EQUIPMENT AND BORDERS TO BE VERIFIED ON SITE TO ENSURE ADEQUATE SAFETY ZONES, AND TO VERIFY REQUIRED QUANTITY OF SURFACING MATERIAL.

ROSS GLEN
ACCESSIBLE PLAYGROUND

MEDICINE HAT, AB

PRODUCTS BY BLUE IMP-1S

LAYOUT #: A100338R5
JOB #: J00238

RECOMMENDED AGES: AS NOTED
AREA REQ'D (SQ.FT): 4991
PERIMETER REQ'D (FT): 255
DRAWN BY: EH
DATE: 15-JUL-10



766 - 14TH STREET S.W.
MEDICINE HAT, AB. T1A 4V7
TOLL FREE: 1-800-661-1462
FAX: (403) 529-0851

E-MAIL: sales@blueimp.com WEBSITE: www.blueimp.com